



Maura Healey, Governor
Kimberley Driscoll, Lieutenant Governor
Phillip Eng, Interim MassDOT Secretary
Jonathan L. Gulliver, Undersecretary and Highway Administrator



July 30, 2026

610800-135580

ADDENDUM NO. 1

To Prospective Bidders and Others on:

BARNSTABLE
FAP NO. CRP-003S(984)X
Park and Ride Expansion and Improvements at Route 132

THIS PROPOSAL TO BE OPENED AND READ: TUESDAY, AUGUST 18, 2026 at 2:00 P.M.

Transmitting revisions to the Contract Documents as follows:

QUESTIONS AND RESPONSES: One page.

PLANS: Revised sheets 34 and 36 of 87.

Take note of the above, substitute the revised plan sheets for the originals, and acknowledge Addendum No. 1 in your Expedite Proposal file before submitting your bid.

Very truly yours,

for
Eric M. Cardone, P.E.
Construction Contracts Engineer

HA
cc: Herrio Lamothe, Project Manager

THIS PAGE IS INTENTIONALLY LEFT BLANK

BARNSTABLE
PARK AND RIDE EXPANSION AND IMPROVEMENTS AT ROUTE 132
(610800-135580)

Questions and Responses

Addendum No. 1, July 30, 2026

Lawrence-Lynch Corp., email dated July 23, 2026

Question 1

Please provide a detail sheet for Arrows & Legends.

Response 1

See revised plan sheet 36 of 87 for symbol details.

Question 2

How wide are the crosswalk markings?

Response 2

See details on revised plan sheet 36 of 87 noting 12" wide strokes.

Question 3

Are the Handicap Symbols Preformed Thermoplastic? Are they ADA with the blue background?

Response 3

The ADA symbol detail is provided on revised plan sheet 36 of 87 and shall have blue background. Preformed thermoplastic should be used.

Question 4

Are there EV Symbols? Are they Preformed? What style are they?

Response 4

There are no EV pavement markings proposed.

Question 5

How tall are all the letters? There are different sizes on the plan.

Response 5

Dimensions have been added for the letter heights on revised plan sheet 34 of 87.

THIS PAGE IS INTENTIONALLY LEFT BLANK

STATE	FED. AID PROJ. NO.	SHEET NO.	TOTAL SHEETS
MA	CRP-003S(984)X	34	87
PROJECT FILE NO.		610800	




$$\frac{1}{2} \quad | \quad \backslash$$


TRAFFIC SIGN SUMMARY & PAVEMENT MARKING DETAILS

BARNSTABLE
BARNSTABLE PARK AND RIDE

STATE	FED. AID PROJ. NO.	SHEET NO.	TOTAL SHEETS
MA	CRP-003S(984)X	36	87
PROJECT FILE NO.		610800	

TRAFFIC SIGN SUMMARY SHEET

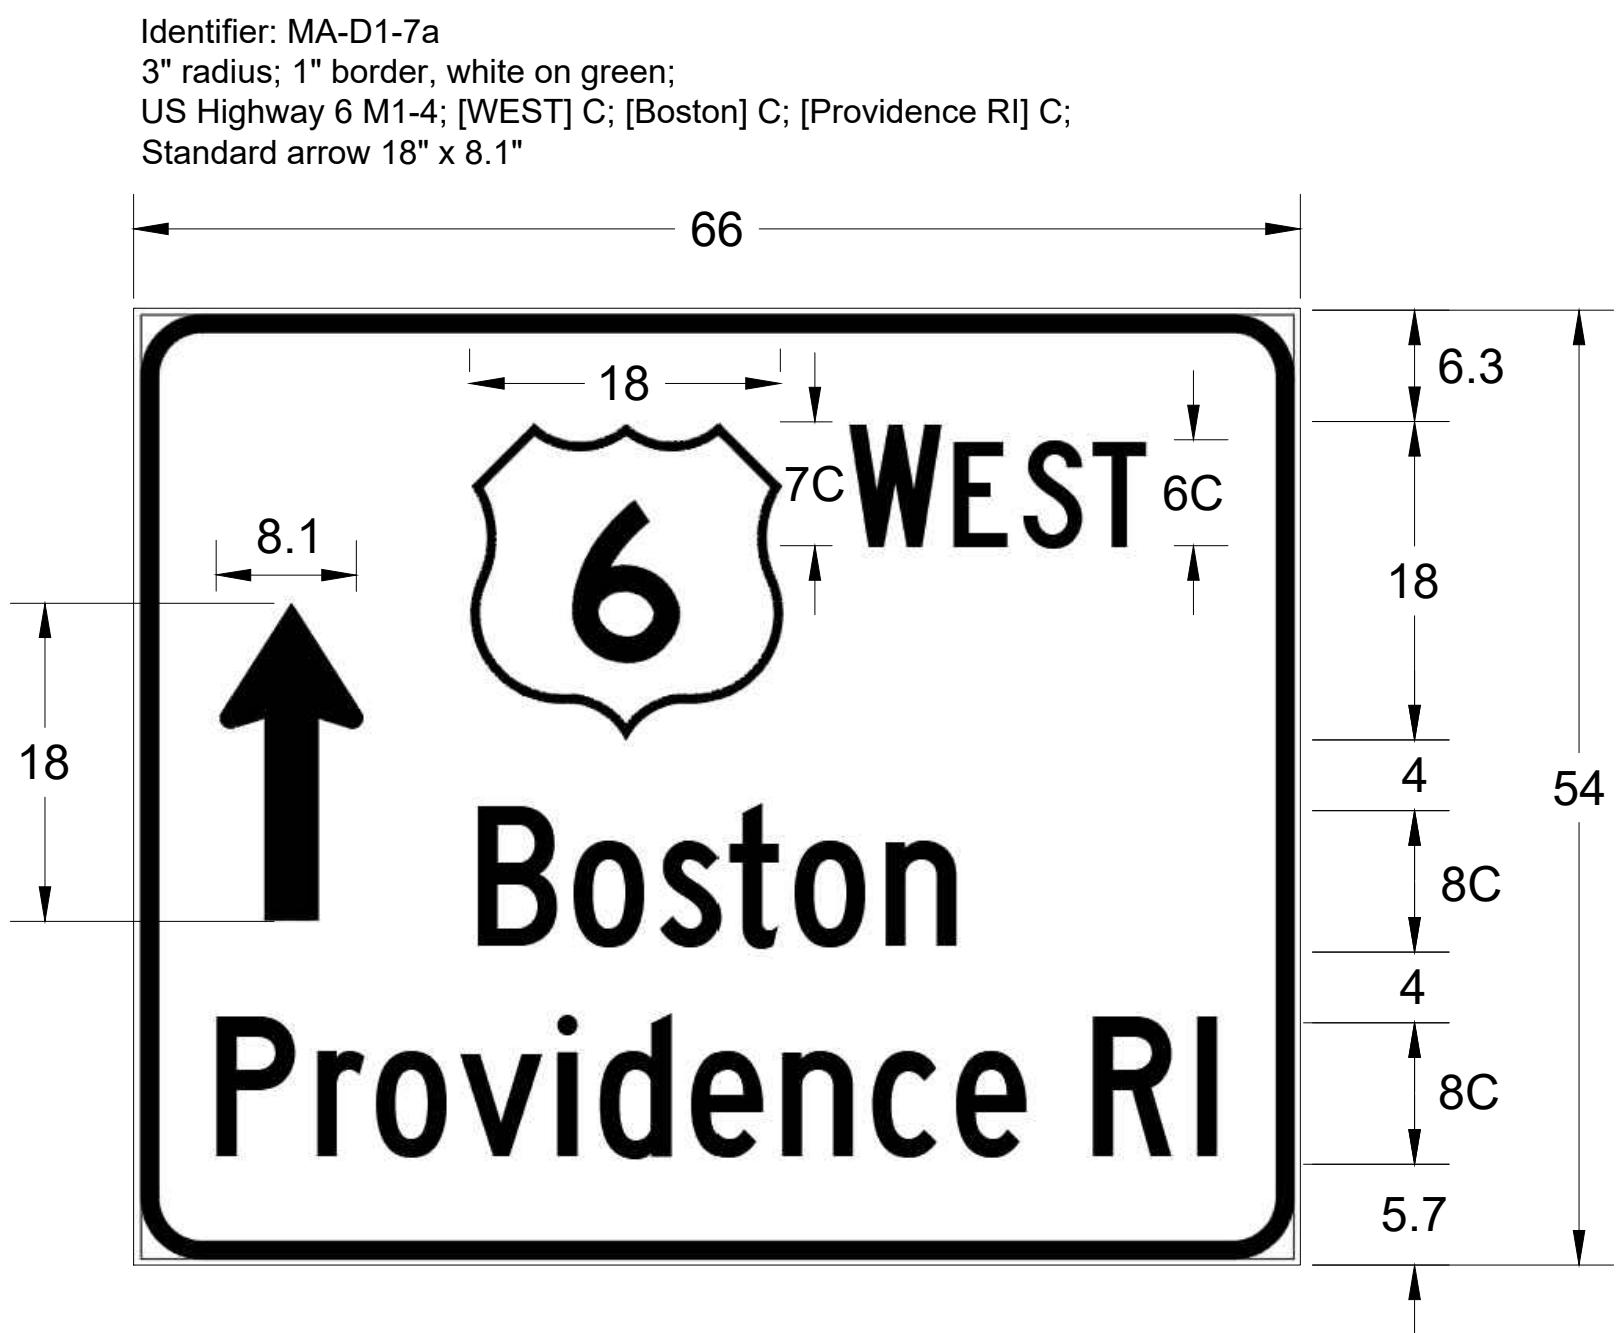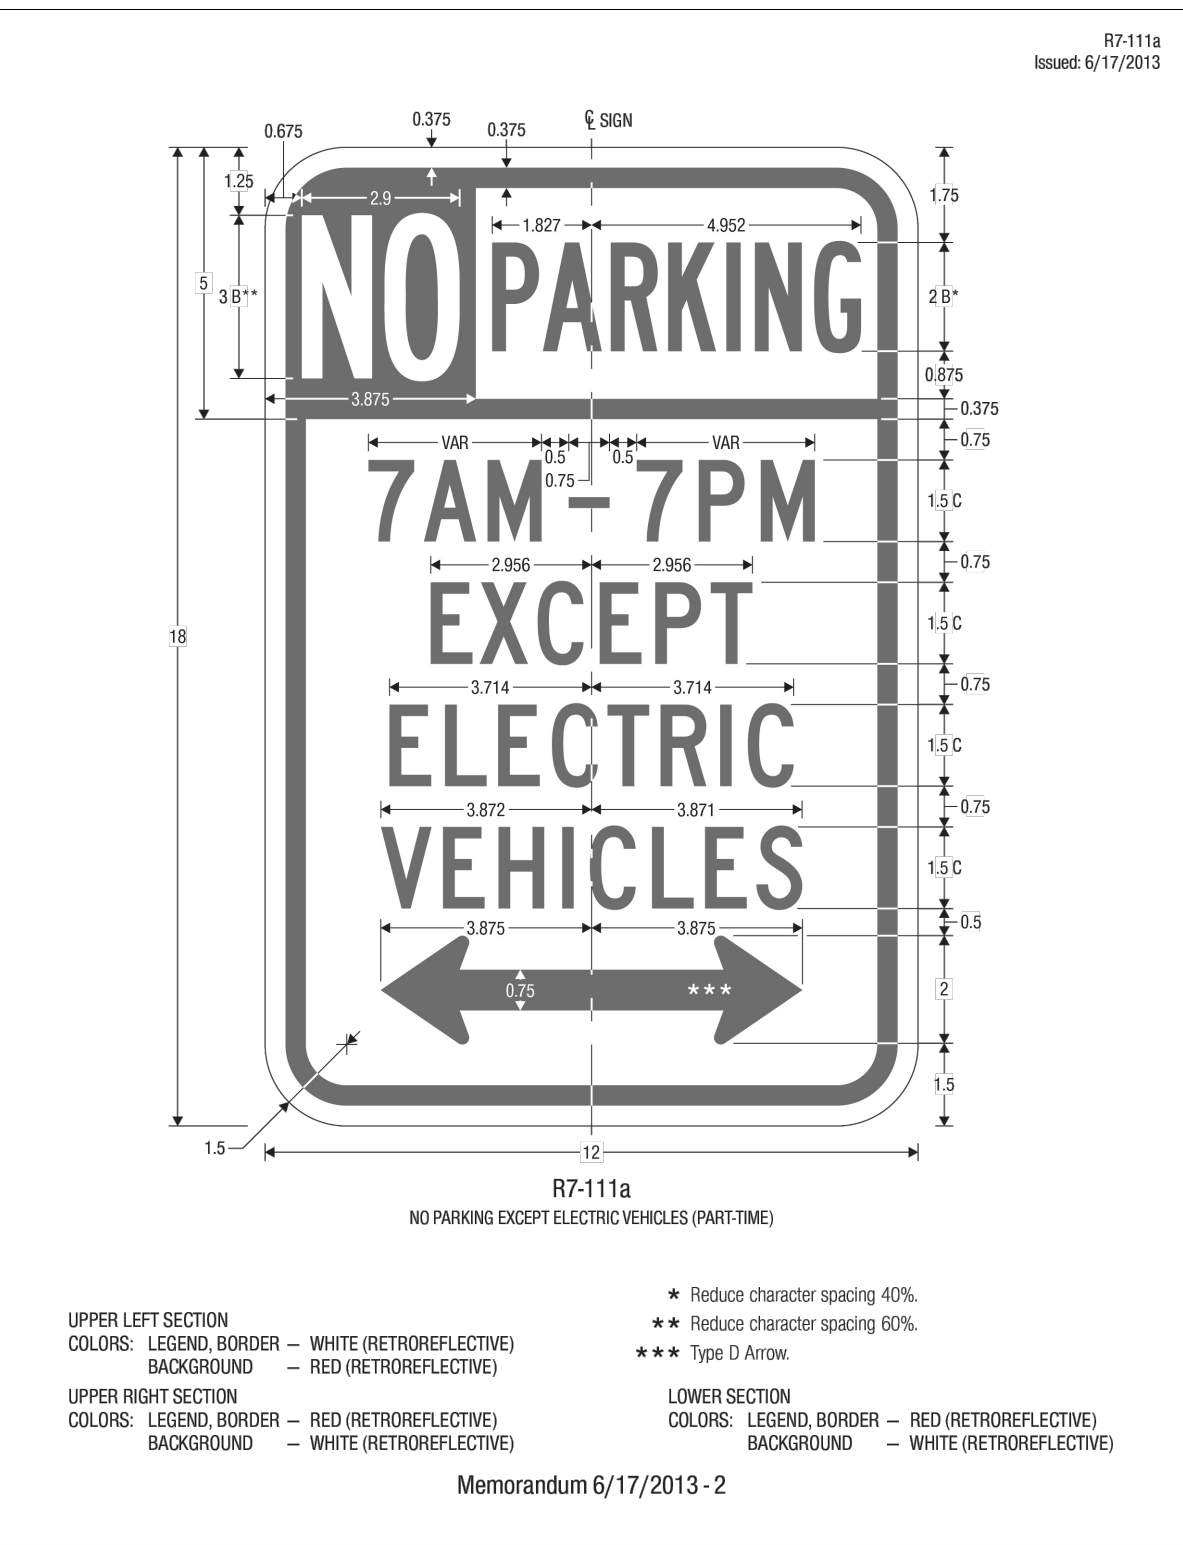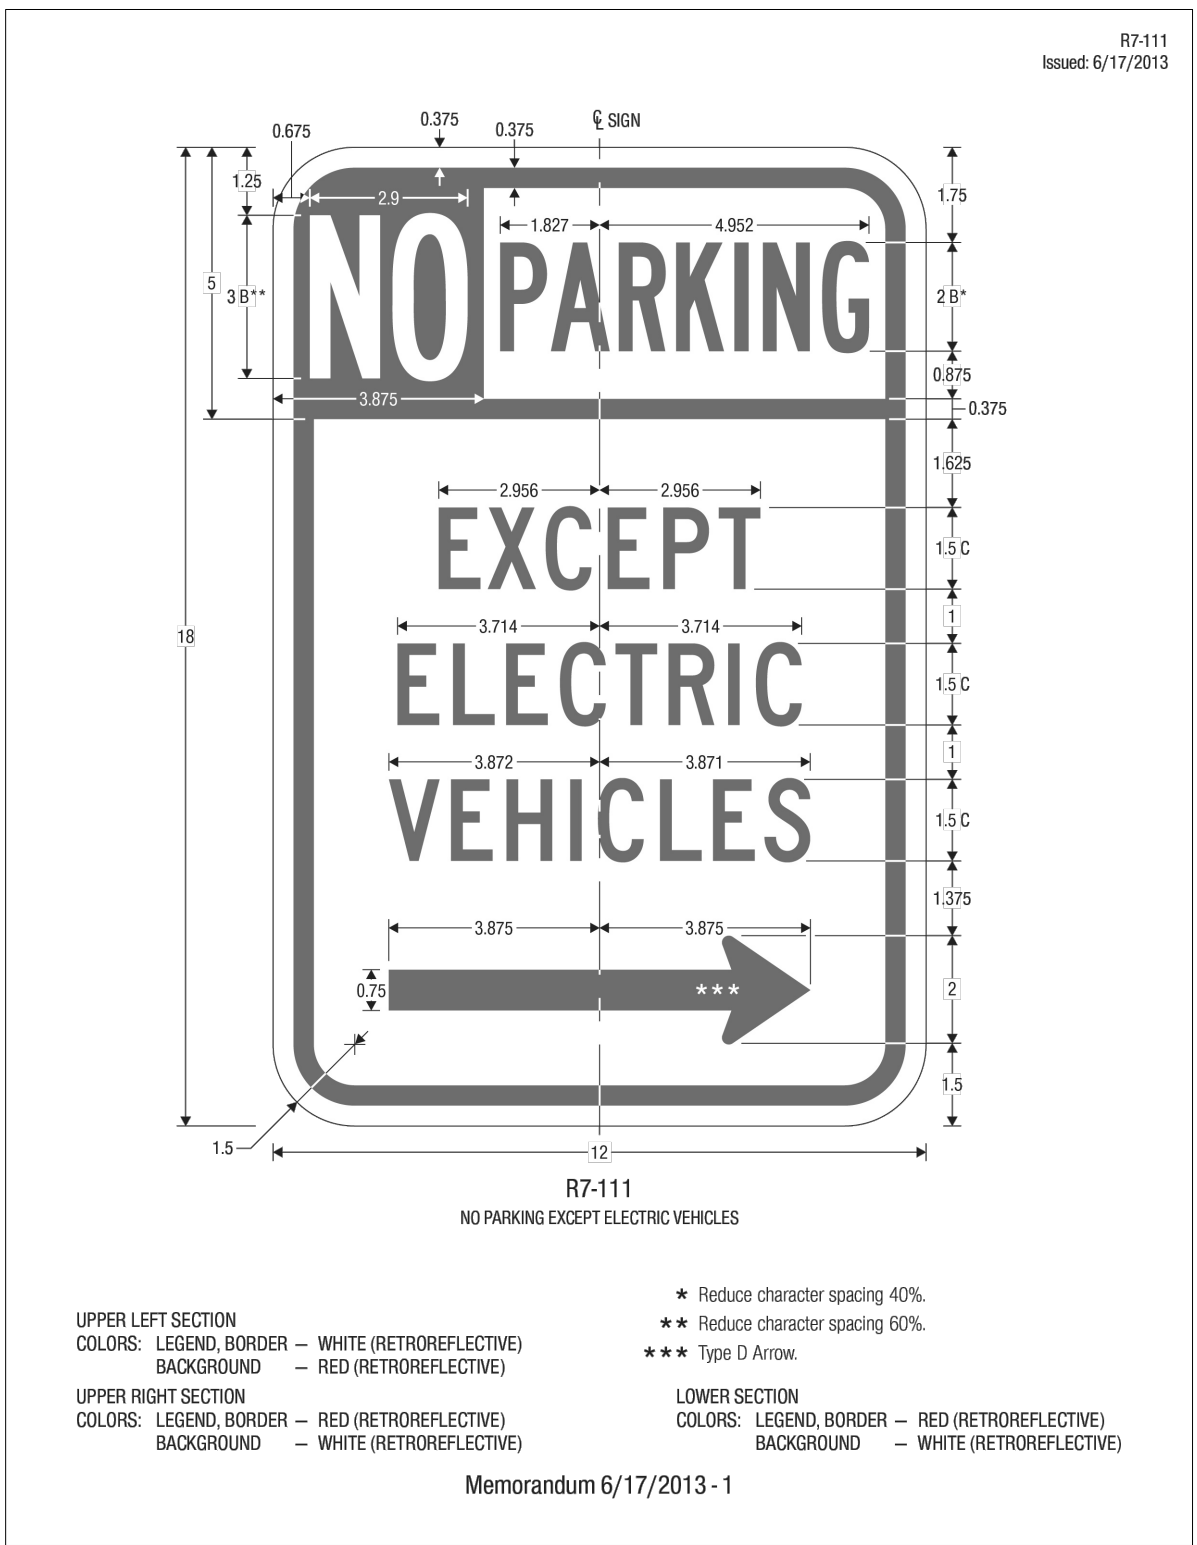

Identifier: MA-D1-7b
3" radius; 1" border, white on green;
US Highway 6 M1-4; [WEST] C; [Boston] C; [Providence RI] C;
US Highway 6 M1-4; [EAST] C; [Provincetown] C;
Standard arrow 18" x 8.1"

