


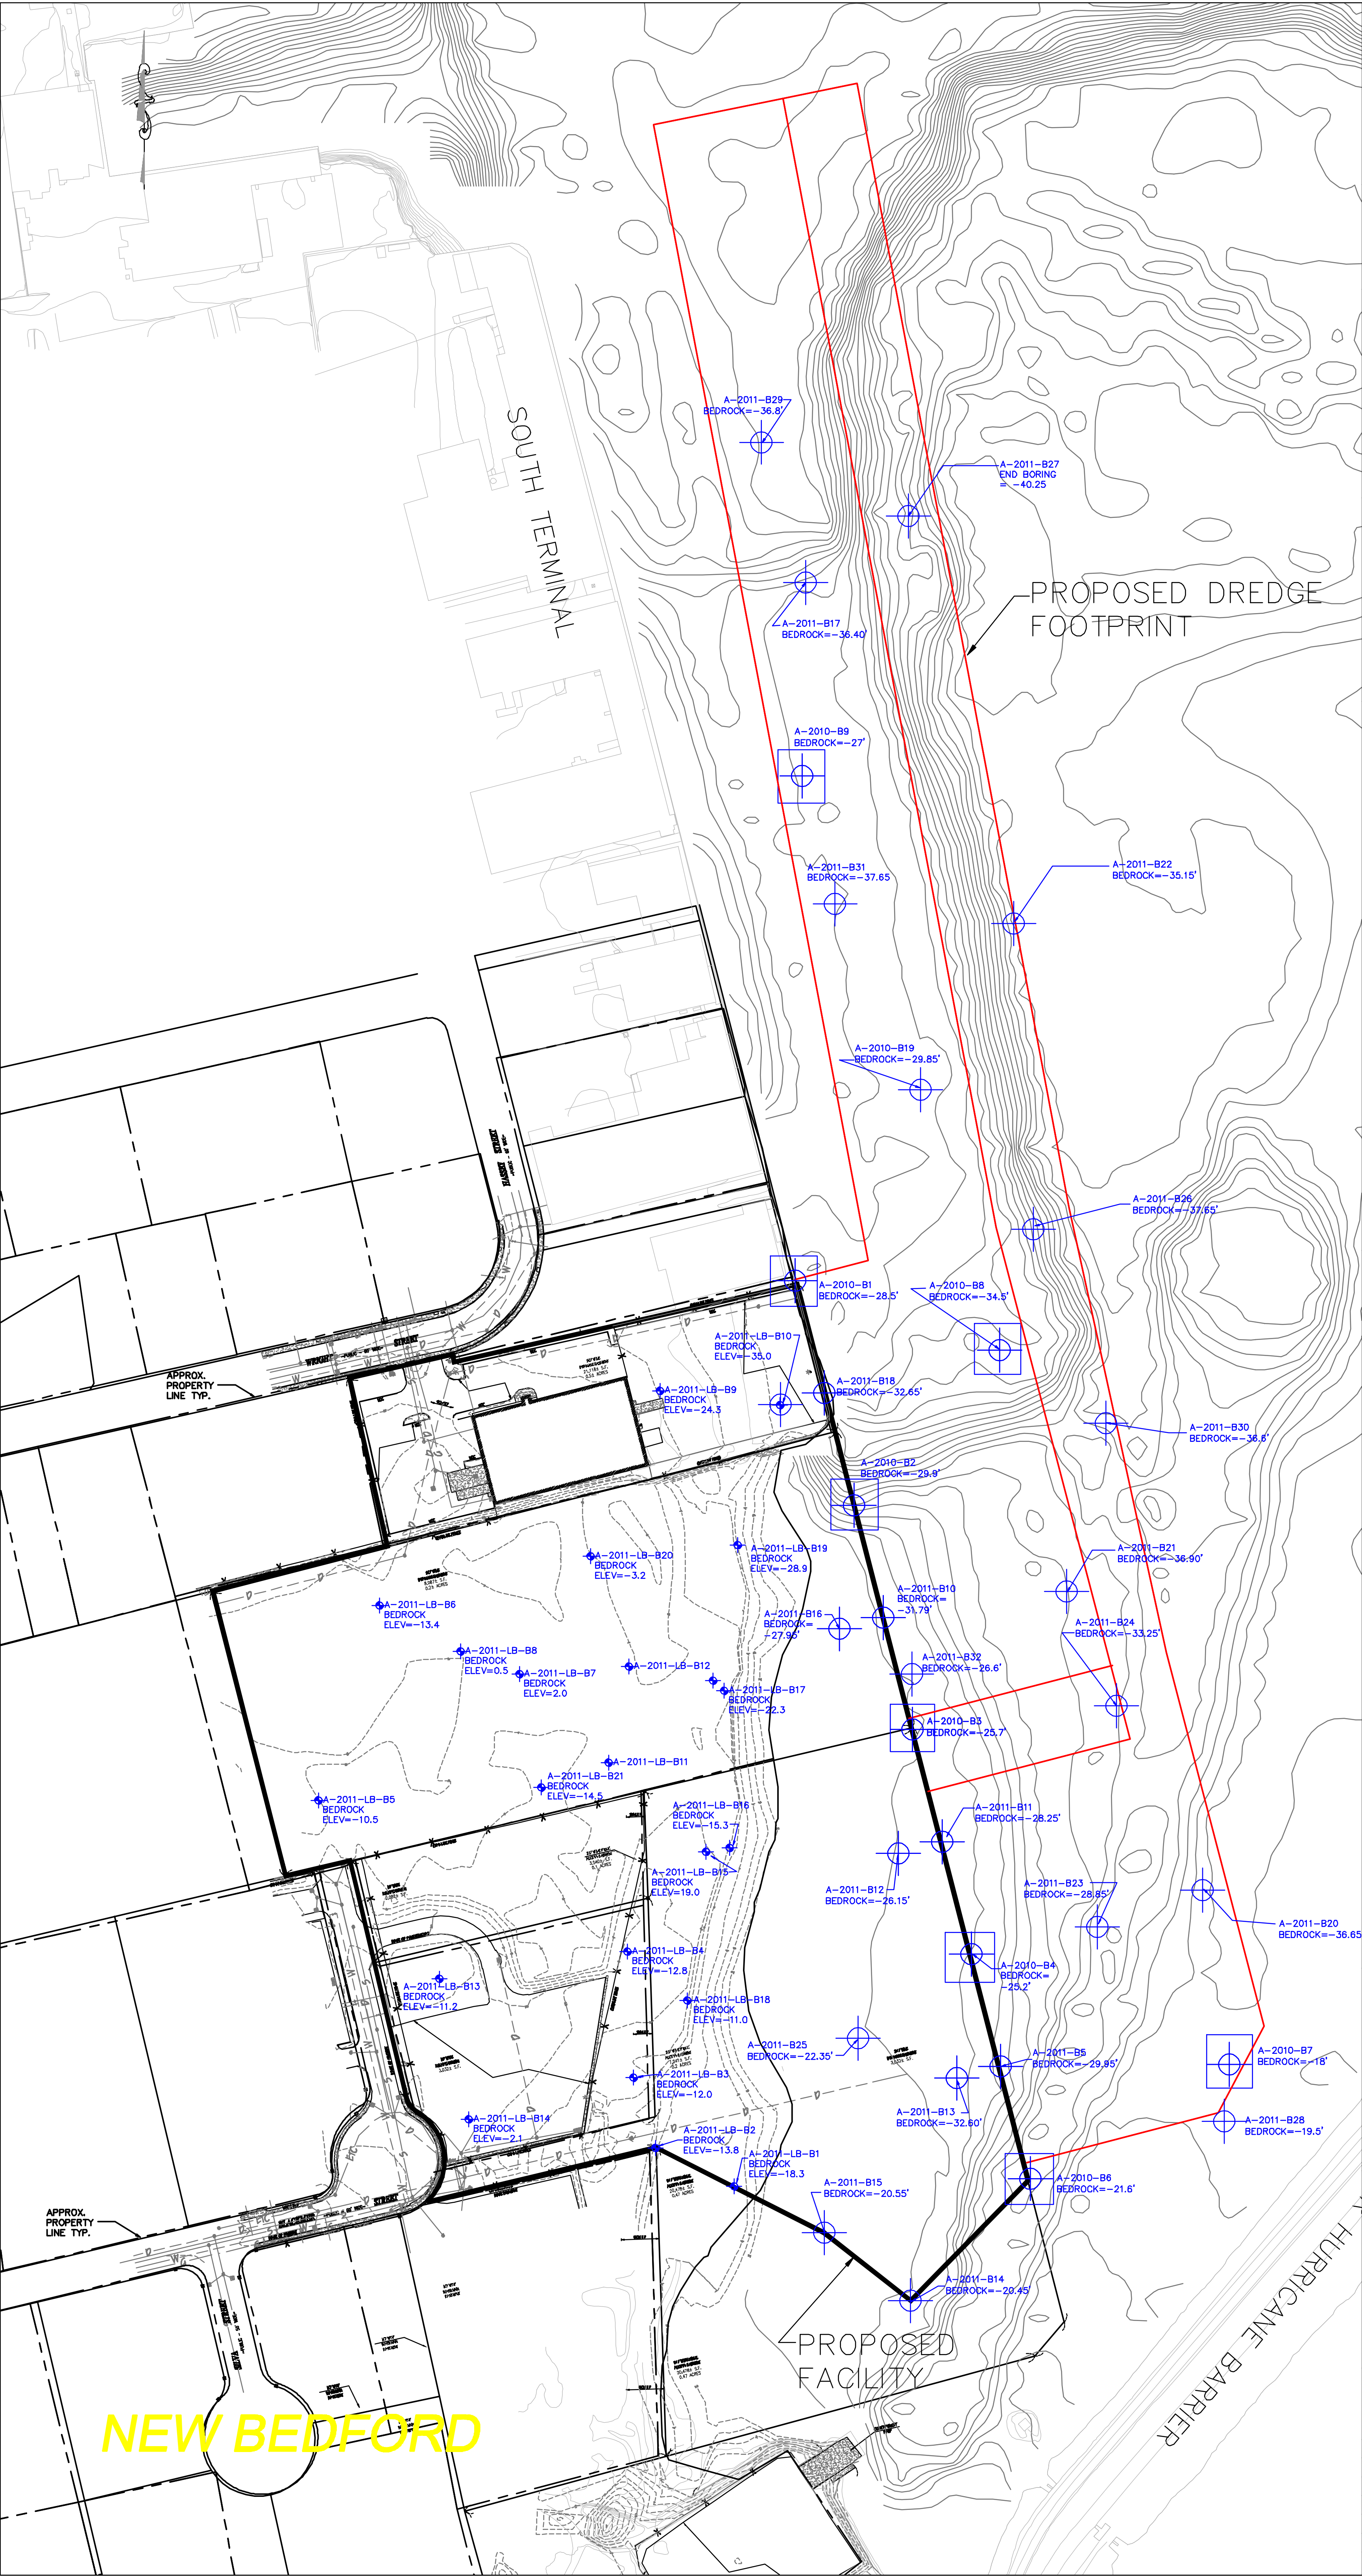

184 HIGH STREET
SUITE 502
BOSTON MA 02110
(617) 728-0070

REVISIONS		
#	DATE	DESCRIPTION
1	7/11/11	LAND BORINGS

THESE DRAWINGS PREPARED BY APEX FOR THIS PROJECT ARE INSTRUMENTS OF APEX'S SERVICE FOR USE SOLELY WITH RESPECT TO THIS PROJECT, AND APEX SHALL BE DEEMED THE AUTHOR OF THE DRAWING AND SHALL RETAIN ALL COMMON LAW, STATUTORY AND OTHER RESERVED RIGHTS WITH RESPECT THERETO, INCLUDING COPYRIGHT. THE DOCUMENTS SHALL NOT BE USED ON OTHER PROJECTS, FOR ADDITIONS TO THIS PROJECT OR FOR COMPLETION OF THIS PROJECT BY OTHERS, EXCEPT BY AGREEMENT IN WRITING AND WITH APPROPRIATE COMPENSATION TO APEX.

- NOTES:
1. THE PROPOSED BORING LOCATIONS SHOWN HEREON ARE APPROXIMATE.
 2. PROPERTY LINES AND OWNERSHIP SHOWN HEREON ARE FOR REFERENCE ONLY AND BASED ON AN ELECTRONIC PLAN PROVIDED BY THOMPSON FARLAND, INC. THIS PLAN IS NOT INTENDED TO BE USED AS A PLAN OF RECORD, OR FOR THE DETERMINATION OF PROPERTY LINES, BOUNDARIES, OR LINES OF OWNERSHIP.
 3. BACKGROUND IMAGES SHOWN HEREON ARE PROVIDED COURTESY OF MASSGIS.
 4. STRUCTURES AND FEATURES LOCATED BEYOND THE PROJECT LIMITS, ARE TAKEN FROM AN AERIAL SURVEY CONDUCTED BY THE ARMY CORPS OF ENGINEERS AND SHOULD BE CONSIDERED APPROXIMATE.

- Legend:
- UPLAND GEOTECHNICAL BORING
 - OVER WATER GEOTECHNICAL BORING

PREPARED FOR:

THE NEW BEDFORD
HARBOR DEVELOPMENT
COMMISSION
NEW BEDFORD,
MASSACHUSETTS

DRAWING TITLE:

SOUTH TERMINAL
MARINE
INFRASTRUCTURE PARK
AS-BUILT BORING
LOCATIONS

Scale: 1"=100'	
0 50 100 200 300 FEET	
Date 10/28/10	Drawing No.
Proj. Mgr.	
Design CWM	
Check JAB	
Drawn GCD	
Job No. 6690	FIG. X
Last Rev. 11/22/10	

NEW BEDFORD